Department of Lands

Integrated Survey of N.S.W

RECONNAISSANCE and MAINTENANCE REPORT 3660 STATION PANANIA T.S. (P)

This Trig. Station has been:-

Note: Cross out word or words which do not apply

Co: CUMBERLAND | Ph:

Map Sheet: | No:

Inspected by: L. M HAYES | Date: 16 – 2 – 76

Authority Dept of Lands | Field Book: PDP 863

1. Completely cleared to permit 360° vision to surrounding Trigs.
2. Cleared by lanes bearing ..... from Trig. Mast
3. Trig. Mast & Vanes have been painted white & black respectively..
4. The Trig. was unpiled/~~not unpiled~~, dimensions now being:

   Description of mark Rooftop Pillar should be explicit, e.g. Steel plug, Brass plug, Bolt, Concrete Pillar

   Height of mark 1·31 m above/below ~~rock/concrete~~ metal platform ——— m above/below G.L.

   Height of Top Vanes to ~~Top Mark~~/Top pillar plate 2·51 m Diameter of Vanes (vertical) 0·61 m.

   Height of Cairn ——— m. Diameter of Cairn ——— m.

   Length of Mast 1·82 m. (approximate if not unpiled)
5. A ..... set in conc/rock has been placed/fd ..... m. bearing ..... °M from Trig. Mast/pillar
6. A ..... set in conc/soil has been placed/fd ..... m. bearing ..... °M from Trig. Mast/pillar
7. A ..... set in conc/soil has been placed/fd ..... m. bearing ..... °M from Trig. Mast/pillar
8. A ..... set in conc/rock has been placed/fd ..... m. bearing ..... °M from Trig. Mast/pillar
9. Connection ..... to ..... : ..... m. bearing ..... °M
10. Connection ..... to ..... : ..... m. bearing ..... °M
11. Connection ..... to ..... : ..... m. bearing ..... °M
12. Connection ..... to ..... : ..... m. bearing ..... °M
13. Diff. Ht. ..... is ..... m. above/below .....
14. Diff. Ht. ..... is ..... m. above/below .....
15. Diff. Ht. ..... is ..... m. above/below .....
16. Diff. Ht. ..... is ..... m. above/below .....

Prepared by: L.M HAYES 17-2-76. Checked: [illegible]

Beacon Diagram — Not to Scale

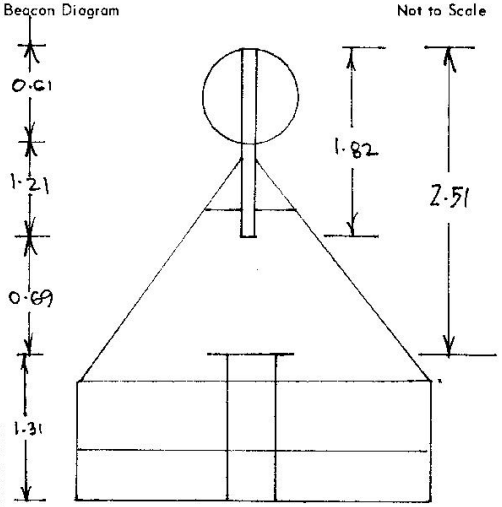

Date	Record of Station

TS3660 | Print Date: 31/05/2022 16:19 | No Of Pages: 2 | Property of DFSI – Spatial Services

STATION PANAN T.S. 3660

Station Diagram

Not to Scale

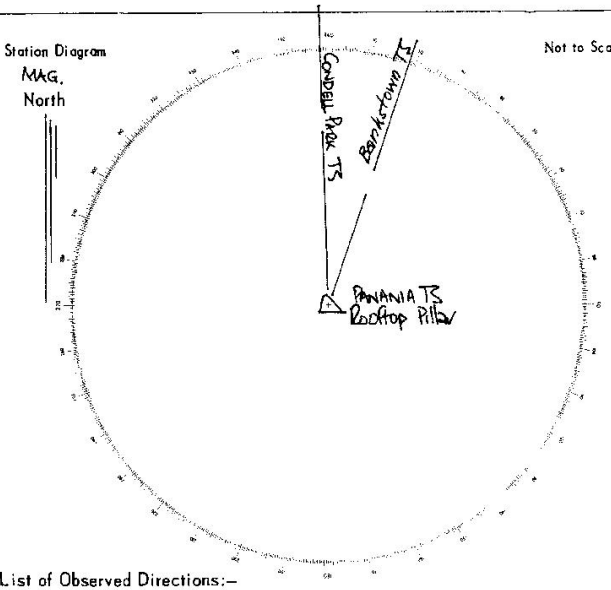

Owners Name.....

Address.....

.....

Current Occupant.....

Address.....

.....

Access CONVENTIONAL VEHICLE

Note WATERBOARD KEY IS NECESSARY FOR ACCESS TO TRIG

LBD MAP 96 C-3.

Access off Lawler St

List of Observed Directions:–

Standpoint: Rooftop Pillar

Station	Direction
Condell Park TS	359 59' 60"
Bankstown T.S.	18° 47' 14"

Standpoint:

Station	Direction

Station	Direction

Station	Direction

D. West, Government Printer, New South Wales — 1976

TS3660 | Print Date: 31/05/2022 16:19 | No Of Pages: 2 | Property of DFSI – Spatial Services