

CENTRAL MAPPING AUTHORITY

GEODETIC SURVEY OF N.S.W.


GEODETIC STATION RECONNAISSANCE and MAINTENANCE REPORT

STATION: TILLABUGGERY No.: 4375

MAP SHEET SCALE 1:250 000 BEGA

INSPECTED BY: B. Green DATE: 11/1/80

AUTHORITY: D.L.R. FIELD BOOK:

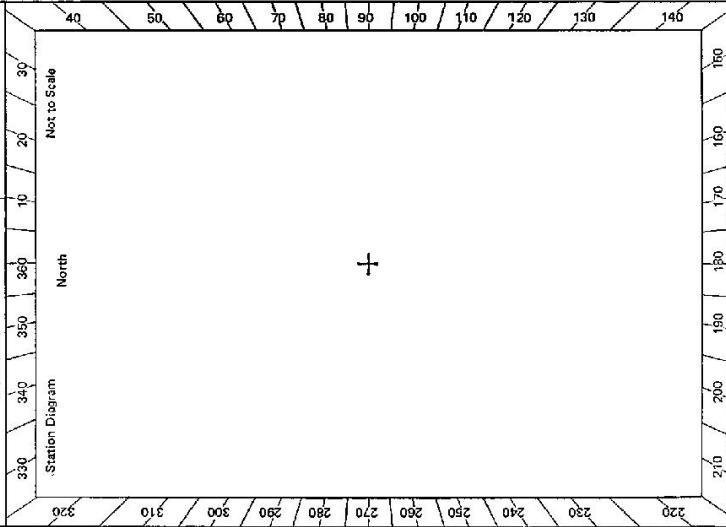

Description: Cleared by lanes bearing 360° . *Note: Cross out word or words which do not apply*

1. ~~Mast~~ ~~has been painted white & black respectively.~~

3. The station/pillar was unplied/not unplied/constructed on 19 dimensions now being:

Description of mark: Brass Plug should be explicit, e.g., S/Steel Pillar Plate, Steel plug, Brass plug, Bolt, G.I. Pipe

Height of mark: 0.0 m. ^{above} rock/concrete; Mark is m. ^{above} G.L.

Height of Top Vanes to Top Mark/Pillar plate m. Diameter of Vanes (vertical) m.

Height of Cairn m. Diameter of Cairn m. Name Plate found/not found/placed.

Length of Mast m. (approximate if not unplied)

4. A. set in conc/rock has been placed/..... bearing 128° M ~~from Mast/Plug/Pillar~~

5. A. set in conc/rock has been placed/round, bearing $^\circ$ M from Mast/Plug/Pillar

6. A. set in conc/rock has been placed/round, bearing $^\circ$ M from Mast/Plug/Pillar

7. A. set in conc/rock has been placed/round, bearing $^\circ$ M from Mast/Plug/Pillar

8. Action required:.....

STANDPOINT: Tillabuggerry SSM

Mark	Direction	Horiz. Distance	Height Difference	Mark	Direction	Horiz. Distance	Height Difference
Cosgrove ECC	$0^\circ 50' 59''$	24008	above standpt				above standpt
Harnet T.S.	$6^\circ 05' 40''$	8187	below				below standpt
Umaralla T.S.	$87^\circ 59' 51''$	22998	above standpt				above standpt
Cooma ECC.	$230^\circ 21' 40''$	8000	below				below standpt
			below				below standpt
			above standpt				above standpt
			below				below standpt
			above standpt				above standpt
			below				below standpt

Prepared by: Noted on U.T.M. Card Checked by: B. Green

CENTRAL MAPPING AUTHORITY

GEODETIC SURVEY OF N.S.W.

GEODETIC STATION RECONNAISSANCE and MAINTENANCE REPORT

Description:

1. Cleared by vanes bearing clear 360° except for tower (concentric) from Trig. Mast
 Note: *Cross out word or words which do not apply*

2. Mast & Vanes have been painted white & black respectively.

3. The station/pillar was unpainted/repainted/constructed on 31 August 1990, dimensions now being:

Description of mark Brass Plug should be explicit, e.g. S/Steel Pillar Plate, Steel plug, Brass plug, Bolt, G.I. Pipe

Height of mark m. ^{above} rock/concrete; Mark is m. ^{above} G.L.

Height of Top Vanes to Top Mark/Pillar plate m. Diameter of Vanes (vertical) m.

Height of Cairn m. Diameter of Cairn m. Name Plate found/not found/placed.

Length of Mast m. (approximate if not unplied)

4. A SSM 30506 set in conc/rock has been placed/found, bearing 123.0° M from Mast/Plug/Pillar

5. A G.I. Pipe set in soil has been placed/found, bearing 121.0° M from Mast/Plug/Pillar

6. A set in conc/rock has been placed/found, bearing° M from Mast/Plug/Pillar

7. A set in conc/rock has been placed/found, bearing° M from Mast/Plug/Pillar

8. Action required: Trig Plug (T2 2-ores) STANDPOINT: G.I. Pipe in Soil placed.

Mark	Direction	Horiz. Distance	Height Difference	Mark	Direction	Horiz. Distance	Height Difference	STANDPOINT: SSM 30506	
								Mark	Direction
NUMERALLA (P)	0 00 00		above standpt.	NUMERALLA (P)	0 00 00		above standpt.	0 00 00	
G.I. Pipe	50 38 39	56.971	below standpt.	HUDSONS PEAK (P)	88 31 295		below standpt.	50 25 25	
SSM 30506	52 50 30	5.456	above standpt.	Trig Plug	230 45 14	56.972	above standpt.	88 29 24-2	
HUDSONS PEAK (P)	88 28 05		below standpt.				below standpt.	232 50 52	
			above standpt.				above standpt.		
			below standpt.				below standpt.		
			above standpt.				above standpt.		
			below standpt.				below standpt.		
