CENTRAL MAPPING AUTHORITY

GEODETIC SURVEY OF N.S.W.

GEODETIC STATION RECONNAISSANCE and MAINTENANCE REPORT

STATION: TUMBLEDOWN	No.: 4469
MAP SHEET SCALE 1:250 000 WOLLONGONG	
INSPECTED BY: G. KEEP	DATE: 20/7/81.
AUTHORITY: C.M.A.	FIELD BOOK:

Description: *Note: Cross out word or words which do not apply*

1. Cleared by lanes bearing..... from Trig. Mast
2. Mast & Vanes have been painted white & black respectively.
3. The station/pillar was unpiled/not unpiled/constructed on.....19....., dimensions now being:

   Description of mark.....should be explicit, e.g., S/Steel Pillar Plate, Steel plug, Brass plug, Bolt, G.I. Pipe

   Height of mark.....m. above/below rock/concrete; Mark is.....m. above/below G.L.

   Height of Top Vanes to Top Mark/Pillar plate ....3·4.....m. Diameter of Vanes (vertical)....1·00....m.

   Height of Cairn.....1·1.....m. Diameter of Cairn....2·2....m. Name Plate found/not found/placed.

   Length of Mast .....2·4.....m. (approximate if not unpiled)
4. A....G.I. pipe.....set in conc/~~rock~~ has been ~~placed~~/found, bearing....96....°M to ~~from~~ Mast/~~Plug/Pillar~~ @ 4·9 m
5. A....G.I. pipe.....set in conc/~~rock~~ has been ~~placed~~/found, bearing....39....°M to ~~from~~ Mast/~~Plug/Pillar~~ @ 9·9 m
6. A....SSM.....set in conc/~~rock~~ has been ~~placed~~/found, bearing....34....°M to ~~from~~ Mast/~~Plug/Pillar~~ @ 5·2 m
7. A.....set in conc/rock has been placed/found, bearing.....°M from Mast/Plug/Pillar
8. Action required:....360° clearing necessary.....

Station Diagram — North — Not to Scale

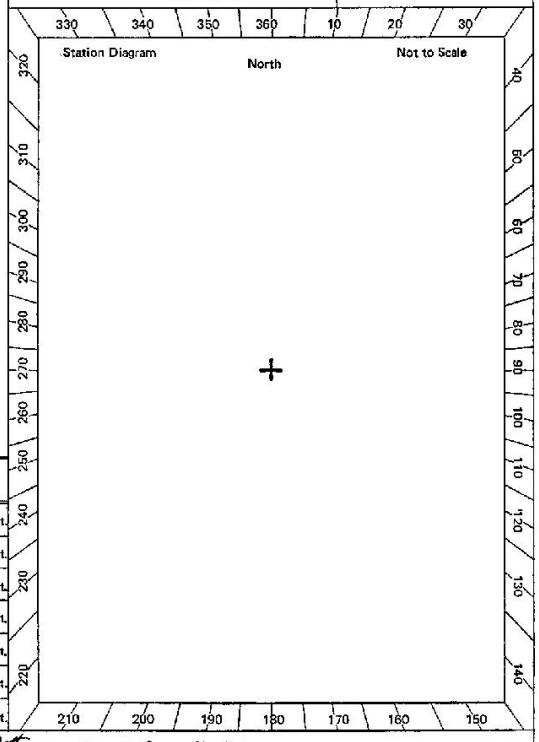

STANDPOINT:

Mark	Direction	Horiz. Distance	Height Difference
			above/below standpt.
			above/below standpt.
			above/below standpt.
			above/below standpt.
			above/below standpt.
			above/below standpt.
			above/below standpt.

STANDPOINT:

Mark	Direction	Horiz. Distance	Height Difference
			above/below standpt.
			above/below standpt.
			above/below standpt.
			above/below standpt.
			above/below standpt.
			above/below standpt.
			above/below standpt.

Prepared by: Geoffrey Keep 18/8/81. *Checked:* *Noted on U.T.M. Card* J Patton 18.5.85 *Checked*

St 2733–1

TS4469 | Print Date: 31/05/2022 16:33 | No Of Pages: 2 | Property of DFSI – Spatial Services

St 2733–2 D. West, Government Printer

STATION TUMBLEDOWN TS 4469

Beacon Diagram — Not to Scale

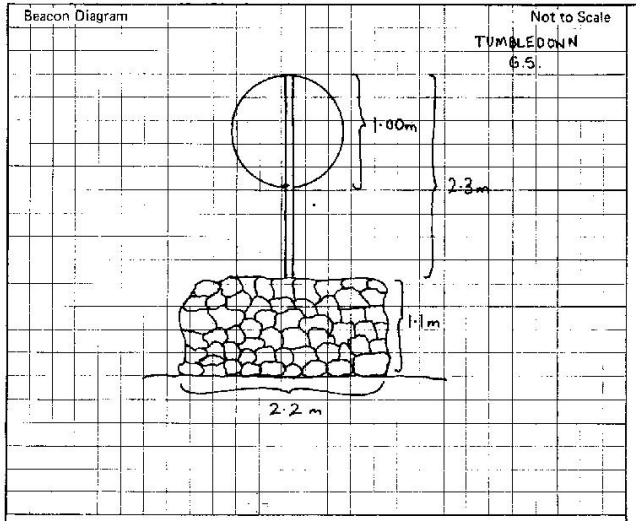

Owner's Name: .....

Address: .....

.....

Phone: .....

Current Occupant: .....

Address: .....

.....

Phone: .....

ACCESS

Access Report of 20/7/1981 was found suitable/unsuitable.

Trig. found in good condition - vanes intact & undamaged, mast straight and cairn stacked. Mast and vanes are painted black & white. 360° clearing necessary.

This section to be completed by officer constructing pillar.

Original station mark found/not found.

Description of mark: .....

Original beacon found/not found.

Description of beacon: .....

Height Top of Vanes to Top Mark.....m.

Height of mark.....m. above/below rock/conc.....m. above/below G.L.

Diameter of Vanes .....m. Height of Cairn .....m.

Original Beacon has/has not been destroyed by me.

Date	Record of Station

TS4469 | Print Date: 31/05/2022 16:33 | No Of Pages: 2 | Property of DFSI – Spatial Services