CENTRAL MAPPING AUTHORITY

GEODETIC SURVEY OF N.S.W.

GEODETIC STATION RECONNAISSANCE and MAINTENANCE REPORT

STATION:	WARRAWAY	No.:	4653
MAP SHEET SCALE 1:250 000	CARGELLIGO		
INSPECTED BY:	G.C. HANNA	DATE:	24/5/79
AUTHORITY:	C.M.A.	FIELD BOOK:	

Description: *Note: Cross out word or words which do not apply*

1. Cleared by lanes bearing.....from Trig. Mast
2. Mast & Vanes have been painted white & black respectively.
3. The station/pillar was unpiled/not unpiled/constructed on.....19....., dimensions now being:

   Description of mark.....should be explicit, e.g., S/Steel Pillar Plate, Steel plug, Brass plug, Bolt, G.I. Pipe

   Height of mark.....m. above/below rock/concrete; Mark is.....m. above/below G.L.

   Height of Top Vanes to Top Mark/Pillar plate .....m. Diameter of Vanes (vertical).....m.

   Height of Cairn.....m. Diameter of Cairn.....m. Name Plate found/not found/placed.

   Length of Mast .....m. (approximate if not unpiled)
4. A.....set in conc/rock has been placed/found, bearing.....°M from Mast/Plug/Pillar
5. A.....set in conc/rock has been placed/found, bearing.....°M from Mast/Plug/Pillar
6. A.....set in conc/rock has been placed/found, bearing.....°M from Mast/Plug/Pillar
7. A.....set in conc/rock has been placed/found, bearing.....°M from Mast/Plug/Pillar
8. Action required:.....

STANDPOINT:

Mark	Direction	Horiz. Distance	Height Difference
			above/below standpt.
			above/below standpt.
			above/below standpt.
			above/below standpt.
			above/below standpt.
			above/below standpt.
			above/below standpt.

STANDPOINT:

Mark	Direction	Horiz. Distance	Height Difference
			above/below standpt.
			above/below standpt.
			above/below standpt.
			above/below standpt.
			above/below standpt.
			above/below standpt.
			above/below standpt.

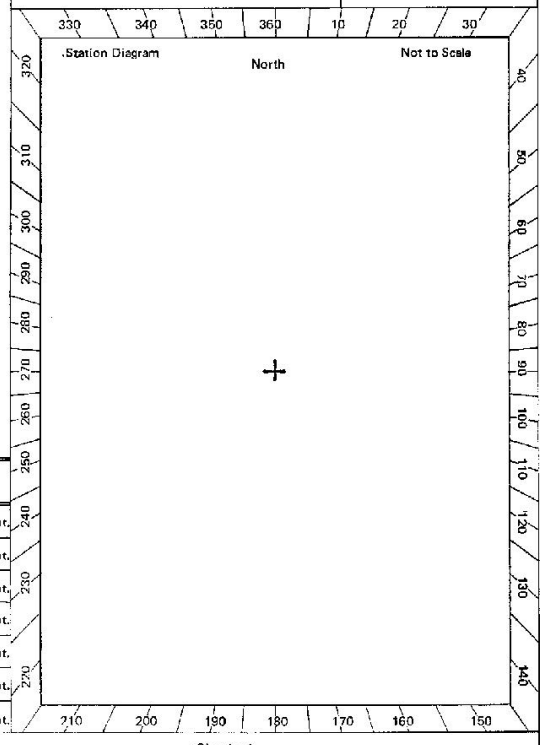

Prepared by: G.C. Hanna 24/5/79 *Checked:* *Noted on U.T.M. Card* *Checked*

St 2733–1

TS4653 | Print Date: 31/05/2022 16:36 | No Of Pages: 2 | Property of DFSI – Spatial Services

TS4653 | Print Date: 31/05/2022 16:36 | No Of Pages: 2 | Property of DFSI – Spatial Services

St 2733–2 D. West, Government Printer

STATION WARRAWAY TS 4653

Beacon Diagram — Not to Scale

Owner's Name: A.J. WRIGHT

Address: "SCOTTS CRAIG"

Phone: LAKE CARGELLIGO 42 K

Current Occupant: .....

Address: .....

Phone: .....

ACCESS See Evabalong 8131-N

Access Report of 24.5./1979 was found suitable/unsuitable.

Cairn, mast & vanes in good order seen on track from "Scotts Craig" about 2 Km to SW.

This section to be completed by officer constructing pillar.

Original station mark found/not found.

Description of mark: .....

Original beacon found/not found.

Description of beacon: .....

Height Top of Vanes to Top Mark.....m.

Height of mark.....m. above/below rock/conc .....m. above/below G.L.

Diameter of Vanes .....m. Height of Cairn .....m.

Original Beacon has/has not been destroyed by me.

Date	Record of Station