Department of Lands

Int[illegible] of N.S.W.

RECONNAISSANCE [illegible] MAINTENANCE REPORT 4732

75-193

STATION	WETHE[illegible]	TS 4732
Co:	Ph:	
Map Sheet:	No:	
Inspected by:	Date:	
Authority	Field Book:	

This Trig. Station has been:-

Note: Cross out word or words which do not apply

1. Completely cleared to permit 360° vision to surrounding Trigs.
2. Cleared by lanes bearing ..... from Trig. Mast

ABSTRACT OF OBSERVATIONS

STATION WETHERILL PARK (GES R.L. 90.0 metres AHD levelled LAND:

To	R.L. (metres)	Direction or Vert. Angle °	'	"	Variance	Observer	Date	Dist. in metres at M.S.L.	Variance	Inst.	Observer	Date
								42.660				
								41.953				
								40.72				
								08.[illegible]				
								1.304				

crete Pillar

m.

pillar

pillar

pillar

pillar

P.D. 4451 RE page 4

NOT TO SCALE

UP EYE

A: directions Corrected to centre

All Vert's corrected ground to ground

SEE REAR OF CARD FOR REMARKS

G 30

13. Diff. Ht. ..... is ..... m. above below .....
14. Diff. Ht. ..... is ..... m. above below .....
15. Diff. Ht. ..... is ..... m. above below .....
16. Diff. Ht. ..... is ..... m. above below .....

Prepared by: *Checked:*

Beacon Diagram Not to Scale

Date	Record of Station

TS4732 | Print Date: 31/05/2022 16:37 | No Of Pages: 2 | Property of DFSI – Spatial Services

STATION THERILL PARK (P) TS 4732

Station Diagram

Not to Scale

North

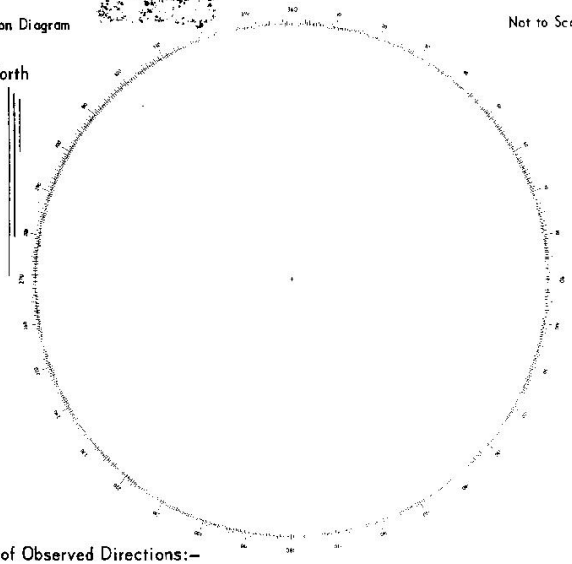

Owners Name

Address

Access

Current Occupant

Address

WETHERILL PARK RES

R 138

To

Remarks

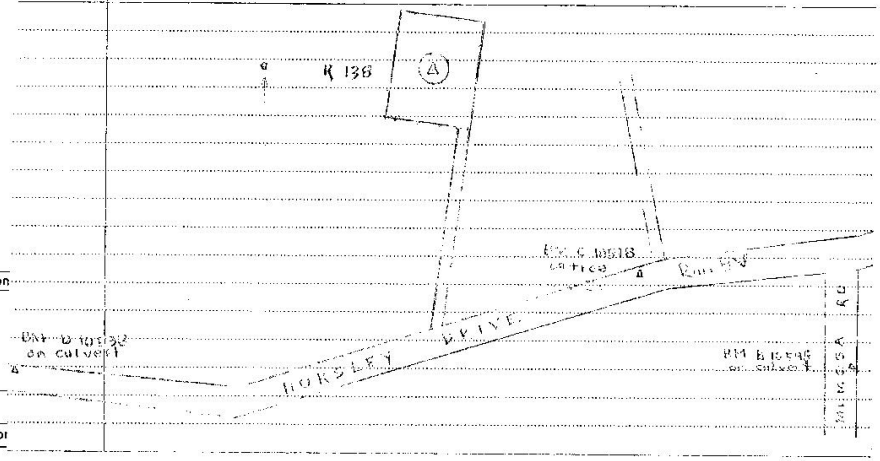

List of Observed Directions:–

Standpoint:

Station	Direction	Station	Direction

Standpoint:

Station	Direction	Station	Direction

D. West, Government Printer, New South Wales — 1976

TS4732 | Print Date: 31/05/2022 16:37 | No Of Pages: 2 | Property of DFSI – Spatial Services