TS4763 | Print Date: 31/05/2022 16:38 | No Of Pages: 2 | Property of DFSI – Spatial Services

Department of Lands

Integration vey of N.S.W.

RECONNAISSANCE and MAINTENANCE REPORT

75-10 3

STATION TS WILKINS 4763

Co: CUMBERLAND Ph: BROKEN BAY

Map Sheet: TERRY HILLS No: 1867-I

Inspected by: J.S. CASSIDY Date: 24/6/82

Authority S.C.B. Field Book:

This Trig. Station has been:-

Note: Cross out word or words which do not apply

1. ~~Completely cleared to permit 360° vision to surrounding Trigs.~~
2. Cleared by lanes bearing No lanes cleared. Dense scrub and timber from Trig. Mast
3. Trig. Mast & Vanes have been painted white & black respectively.
   No MAST or VANES
4. The Trig. was unpiled/~~not unpiled~~, dimensions now being:

   Description of mark NOT SEARCHED FOR ..... should be explicit, e.g. Steel plug, Brass plug, Bolt, Concrete Pillar

   Height of mark.....m above/below rock/concrete .....m above/below G.L.

   Height of Top Vanes to Top Mark/Top pillar plate .....m Diameter of Vanes (vertical).....m.

   Height of Cairn 1·6 m. Diameter of Cairn 2·5 m.

   Length of Mast.....m. (approximate if not unpiled)
5. A.....set in conc/rock has been placed/fd .....m. bearing.....°M from Trig. Mast/pillar
6. A.....set in conc/soil has been placed/fd .....m. bearing.....°M from Trig. Mast/pillar
7. A.....set in conc/soil has been placed/fd .....m. bearing.....°M from Trig. Mast/pillar
8. A.....set in conc/rock has been placed/fd .....m. bearing.....°M from Trig. Mast/pillar
9. Connection.....to..... : ..... m. bearing.....°M
10. Connection.....to..... : ..... m. bearing.....°M
11. Connection.....to..... : ..... m. bearing.....°M
12. Connection.....to..... : ..... m. bearing.....°M
13. Diff. Ht. ..... is..... m. above/below .....
14. Diff. Ht. ..... is..... m. above/below .....
15. Diff. Ht. ..... is..... m. above/below .....
16. Diff. Ht. ..... is..... m. above/below .....

Beacon Diagram Not to Scale

No Mast

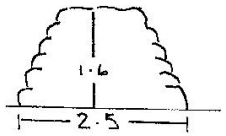

Date	Record of Station

Prepared by: J. CASSIDY Checked: [illegible]

STATION T.S. WILKINS 4763

Station Diagram — Not to Scale

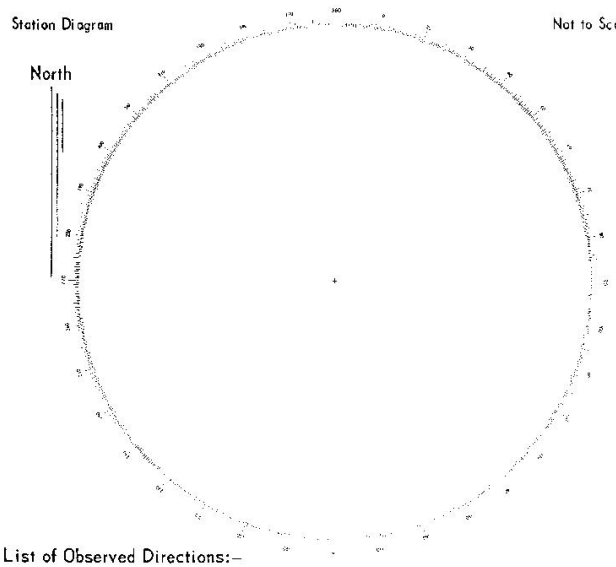

List of Observed Directions:–

Standpoint: Standpoint:

Station	Direction	Station	Direction

Station	Direction	Station	Direction

Owners Name: N.P.&W.S. Current Occupant:

Address: Ku-ring-gai Nat. Park Address:

Access: 24/6/82.
* Note: Key to lock obtained from Ranger H.Q. Dobbin Head Rd.

00 Int's'n Booralie Rd and Mallawa Rd. Go N.W. along Mallawa Rd
0.7 Turn left and follow Bulara St.
1.0 Turn right
1.15 Turn left. Sign "Perimeter Trail" Go thru locked barrier and follow track
1.9 Int's'n go straight ahead. "Long track" on left
2.5 Wracked Holden H.R. mod. 4WD. needed to go further.
Follow track approx 700M to int's'n, turn right and go approx 60M to blazed trees. T.S. is abt 30M on left.

TS4763 | Print Date: 31/05/2022 16:38 | No Of Pages: 2 | Property of DFSI – Spatial Services