CENTRAL MAPPING AUTHORITY

GEODETIC SURVEY OF N.S.W.

GEODETIC STATION RECONNAISSANCE and MAINTENANCE REPORT

STATION: YANCO	No.: 4891
MAP SHEETS SCALE 1:250 000 NARRANDERRA	SCALE 1:100 000 GRIFFITH
INSPECTED BY: R.ELLIS	DATE: 5-06-84
AUTHORITY: C.M.A	FIELD BOOK:

Description: *Note: Cross out word or words which do not apply*

1. ~~XXXXXXXXXXXXXXXXXXXX~~ OVERGROWN 360° LIGHT TIMBER ..... from Trig. Mast (1 to 2 days to clear 360°)
2. ~~Mast & Vanes have been painted white & black respectively.~~
3. The station/~~pillar~~ was ~~XXXXXX~~/not unpiled/~~constructed~~ on.....19....., dimensions now being:

   Description of mark.....should be explicit, e.g., S/Steel Pillar Plate, Steel plug, Brass plug, Bolt, G.I. Pipe

   Height of mark.....m. above/below rock/concrete; Mark is.....m. above/below G.L.

   Height of Top Vanes to Top Mark/Pillar plate .....m. Diameter of Vanes (vertical).....m.

   Height of Cairn 2.0 m. Diameter of Cairn 1.9 m. Name Plate ~~XXX~~ found/not found/~~XXXX~~.

   Length of Mast NO MAST m. (approximate if not unpiled)
4. A.....set in conc/rock has been placed/found, bearing.....°M from Mast/Plug/Pillar
5. A.....set in conc/rock has been placed/found, bearing.....°M from Mast/Plug/Pillar
6. A.....set in conc/rock has been placed/found, bearing.....°M from Mast/Plug/Pillar
7. A.....set in conc/rock has been placed/found, bearing.....°M from Mast/Plug/Pillar
8. Action required:.....

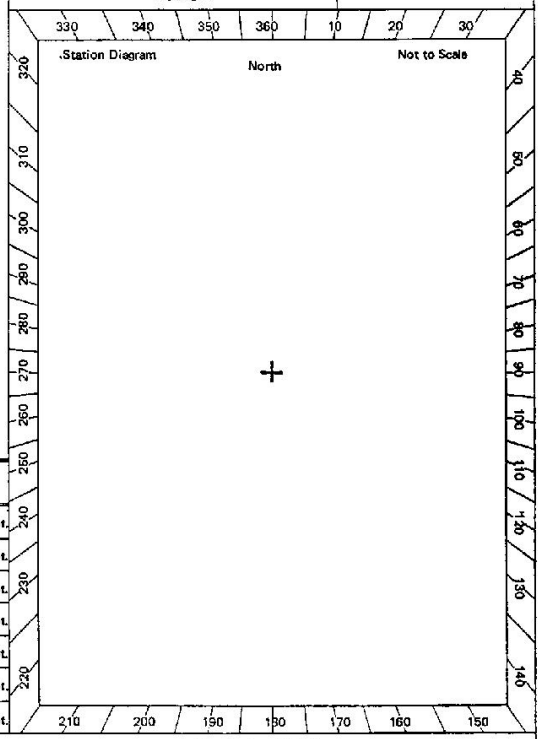

STANDPOINT: Mark	Direction	Horiz. Distance	Height Difference	STANDPOINT: Mark	Direction	Horiz. Distance	Height Difference
			above/below standpt.				above/below standpt.
			above/below standpt.				above/below standpt.
Prepared by: [signature] 13/6/84 *Checked:* *Noted on U.T.M. Card* [signature] *Checked* [signature]

407

TS4891 | Print Date: 31/05/2022 16:40 | No Of Pages: 2 | Property of DFSI – Spatial Services

St 2733—2 D. West, Government Printer

STATION YANCO TS 4891

Beacon Diagram — Not to Scale

Owner's Name: Not known
Address: Possibly a T.R.
Phone:

Current Occupant:
Address:
Phone:

ACCESS

Access Report of 5/6/19.84 was found suitable/unsuitable.

Using MOURA 1:25,000 or YOOGALI 1:50,000 maps drive to south of Round Hill and park at LOCKED GATE.
About a 10 minute walk to Yanco G.S.
Vehicle access would be possible right to G.S. via North side of hill if access could be gained through locked gates.

This section to be completed by officer constructing pillar.

Original station mark found/not found.

Description of mark: .....

Original beacon found/not found.

Description of beacon: .....

Height Top of Vanes to Top Mark.....m.

Height of mark.....m. above/below rock/conc.....m. above/below G.L.

Diameter of Vanes .....m. Height of Cairn .....m.

Original Beacon has/has not been destroyed by me.

Date	Record of Station

TS4891 | Print Date: 31/05/2022 16:40 | No Of Pages: 2 | Property of DFSI – Spatial Services