

GEODETIC SURVEY OF R.S.W.

CENTRAL MAPPING AUTHORITY

GEODETIC STATION RECONNAISSANCE and MAINTENANCE REPORT

Description: *Note: Cross out word or words which do not apply*

1. Cleared by James bearing..... *Note: Cross out word or words which do not apply*
2. Mast & Vanes have been painted white & black respectively.
3. The station pillar was ~~unpainted/not unpainted/constructed on~~..... 19....., dimensions now being: Description of mark: ~~3/5~~ *Pillar*..... should be explicit, e.g., S/Steel Pillar Plate, Steel plug, Brass plug, Bolt, G.I. Pipe
Height of mark..... 1.27..... m. ^{above} ~~rock~~/concrete; Mark is..... 1.27..... m. ^{above} G.L.
Height of Top Vanes to ~~Top~~ *Mark*/Pillar plate *1.50*..... m. Diameter of Vanes (vertical)..... 0.60..... m.
Height of Cairn..... m. Diameter of Cairn..... m. Name Plate found/not found/placed.
Length of Mast..... (approximate if not unpiled)
4. A..... set in conc/rock has been placed/round, bearing..... ° M from Mast/Plug/Pillar
5. A..... set in conc/rock has been placed/round, bearing..... ° M from Mast/Plug/Pillar
6. A..... set in conc/rock has been placed/round, bearing..... ° M from Mast/Plug/Pillar
7. A..... set in conc/rock has been placed/round, bearing..... ° M from Mast/Plug/Pillar
8. Action required.....

| STANDPOINT: | | | |
|-------------|-----------|-----------------|-------------------|
| Mark | Direction | Horiz. Distance | Height Difference |
| | | | above standpt. |
| | | | below standpt. |
| | | | above standpt. |
| | | | below standpt. |
Prepared by: *G. Jones* Checked: *G. Jones* Noted on U.T.M. Card

Sr 2733-1

STATION: **TAREE HOSPITAL** No.: **6058**

MAP SHEET SCALE 1:250 000 *Hastings*

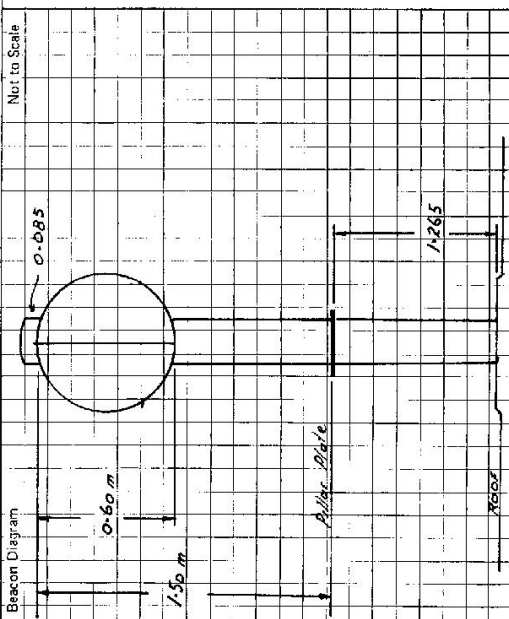
INSPECTED BY: **G Jones** DATE: **3-10-79**

AUTHORITY: **C.M.A.** FIELD BOOK: _____

Station Diagram

Not to Scale

G

| | |
|---|---|
| <p>STATION TARRE HOSPITAL TS 6058</p> <p>Owner's Name: Address: Phone:</p> <p>Current Occupant: Address: Phone:</p> <p>ACCESS Access Report of/19..... was found suitable/unsuitable.</p> |  <p style="font-size: small;">Beacon Diagram</p> <p style="font-size: small;">Not to Scale</p> <p style="font-size: small;">0.60 m</p> <p style="font-size: small;">1.50 m</p> <p style="font-size: small;">Pillar Dia</p> <p style="font-size: small;">1.265</p> |
| <p style="text-align: center; font-size: large; font-weight: bold;">Beacon ONLY</p> | <p>This section to be completed by officer constructing pillar.</p> <p>Original station mark found/not found.</p> <p>Description of mark:</p> <p>Original beacon found/not found.</p> <p>Description of beacon:</p> <p>Height Top of Vanes to Top Markm.</p> <p>Height of markm. above rock/concm. below G.L.</p> <p>Diameter of Vanesm. Height of Cairnm.</p> <p>Original Beacon has/has not been destroyed by me.</p> |
| <p>Date</p> | <p>Record of Station</p> |

CENTRAL MAPPING AUTHORITY

GEODETIC SURVEY OF N.S.W.

GEODETIC STATION RECONNAISSANCE and MAINTENANCE REPORT

Description:

1. Cleared by lanes bearing.....
 Note: Cross out word or words which do not apply from Trig. Mast

2. Mast & Vanes have been painted white & black respectively.

3. The station pillar was unpainted/not emptied/constructed on..... 19....., dimensions now being:

Description of mark: 3/5 Pillar..... should be explicit; e.g., S/Steel Pillar Plate, Steel plug, Brass plug, Bolt, G.I. Pipe

Height of mark: 1.27..... m. above concrete/concrete; Mark is 1.27..... m. above G.L.

Height of Top Vanes to Top-Mark/Pillar plate 1.50..... m. Diameter of Vanes (vertical) 0.60..... m.

Height of Centre..... m. Diameter of Centre..... m. Name-Plate-found/not-found/placed.

Length of Mast..... m. (approximate if not unplied)

4. A..... set in conc/rock has been placed/found, bearing..... °M from Mast/Plug/Pillar

5. A..... set in conc/rock has been placed/found, bearing..... °M from Mast/Plug/Pillar

6. A..... set in conc/rock has been placed/found, bearing..... °M from Mast/Plug/Pillar

7. A..... set in conc/rock has been placed/found, bearing..... °M from Mast/Plug/Pillar

8. Action required:.....

STANDPOINT:

| Mark | Direction | Horiz. Distance | Height Difference | Mark | Direction | Horiz. Distance | Height Difference |
|------|-----------|-----------------|-------------------|------|-----------|-----------------|-------------------|
| | | | above standpt. | | | | above standpt. |
| | | | below standpt. | | | | below standpt. |
| | | | above standpt. | | | | above standpt. |
| | | | below standpt. | | | | below standpt. |
Prepared by: G. Jones

Checked:

Noted on U.T.M. Card

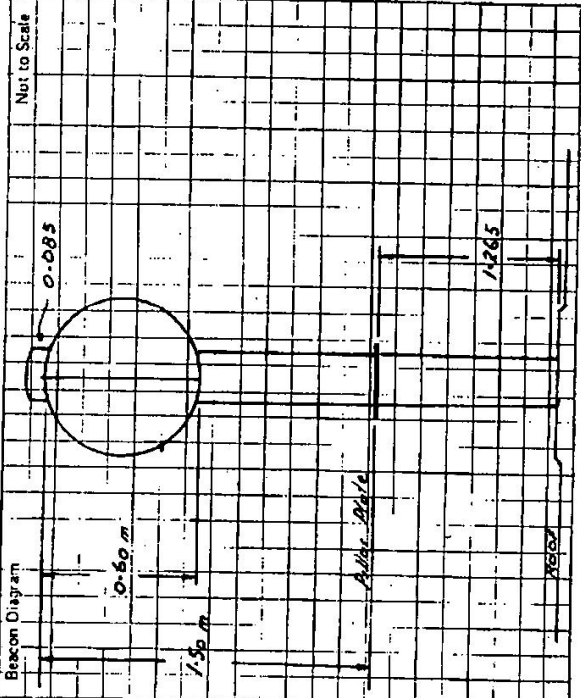
SI 2733-1

STATION: TAREE HOSPITAL No.: 6058
 MAP SHEET SCALE: 1:250 000
 INSPECTED BY: G Jones DATE: 3-10-79
 AUTHORITY: C.M.A. FIELD BOOK:



TS6058

Checked

| | | |
|---|---|---------------------------------------|
| STATION TIRREE HOSPITAL TS 6058 | Owner's Name: Address: Phone: Current Occupant: Address: Phone: Access Report of/...../19 was found suitable/unsuitable. <div style="border: 1px solid black; padding: 5px; width: fit-content; margin: 0 auto;"> ACCESS Beacon Only </div> | Record of Station |
| Beacon Diagram Not to Scale |  | |
| This section to be completed by officer constructing pillar. Original station mark found/not found. Description of mark: Original beacon found/not found. Description of beacon: Height Top of Vanes to Top Mark: m. Height of mark: m. above G.L. below rock/cont. m. Diameter of Vanes: m. Height of Cairn: m. Original Beacon has/hus not been destroyed by me. | | |
| Date | Date: | |

| STATION | TAREE HOSPITAL (P) | |
|---|
| Owners Name..... Address...High St. Taree..... | Current Occupant..... Address..... | |
| <p style="margin: 0;">Access</p> <p style="margin: 0;">The Authority has approved access between the hours of 9.00am to 5.00pm through the maintenance engineers office on the fifth floor. Outside these special arrangements can be made with the above mentioned office</p> | |
| <div style="display: flex; justify-content: space-between;"> <div style="width: 45%;"> <p>Station Diagram</p> </div> <div style="width: 50%;"> <p style="margin: 0;">List of Observed Directions:-</p> <p>Standpoint:</p> <table border="1" style="width: 100%; border-collapse: collapse;"> <thead> <tr> <th style="width: 25%;">Station</th> <th style="width: 50%;">Direction</th> <th style="width: 25%;">Station</th> <th style="width: 25%;">Direction</th> </tr> </thead> <tbody> <tr><td> </td><td> </td><td> </td><td> </td></tr> <tr><td> </td><td> </td><td> </td><td> </td></tr> <tr><td> </td><td> </td><td> </td><td> </td></tr> <tr><td> </td><td> </td><td> </td><td> </td></tr> <tr><td> </td><td> </td><td> </td><td> </td></tr> <tr><td> </td><td> </td><td> </td><td> </td></tr> <tr><td> </td><td> </td><td> </td><td> </td></tr> <tr><td> </td><td> </td><td> </td><td> </td></tr> <tr><td> </td><td> </td><td> </td><td> </td></tr> <tr><td> </td><td> </td><td> </td><td> </td></tr> <tr><td> </td><td> </td><td> </td><td> </td></tr> <tr><td> </td><td> </td><td> </td><td> </td></tr> <tr><td> </td><td> </td><td> </td><td> </td></tr> <tr><td> </td><td> </td><td> </td><td> </td></tr> <tr><td> </td><td> </td><td> </td><td> </td></tr> <tr><td> </td><td> </td><td> </td><td> </td></tr> <tr><td> </td><td> </td><td> </td><td> </td></tr> <tr><td> </td><td> </td><td> </td><td> </td></tr> <tr><td> </td><td> </td><td> </td><td> </td></tr> <tr><td> </td><td> </td><td> </td><td> </td></tr> </tbody> </table> </div> </div> | | Station | Direction | Station | Direction | |
