CENTRAL MAPPING AUTHORITY

GEODETIC SURVEY OF N.S.W.

GEODETIC STATION RECONNAISSANCE and MAINTENANCE REPORT

STATION: BUNNOO PILLAR | No.: 6068

MAP SHEET SCALE 1:250 000: HASTINGS

INSPECTED BY: L.R. HALLIS | DATE: 3RD MAY '78

AUTHORITY: | FIELD BOOK: 01393

Description: *Note: Cross out word or words which do not apply*

1. Cleared by lanes bearing 65 to 190 VISIBILITY RESTRICTED BECAUSE OF POPE from Trig. Mast
2. Mast & Vanes have been painted white & black respectively. ✓
3. The ~~station~~/pillar was ~~unpiled/not unpiled~~/constructed on 27TH MAY 1978, dimensions now being:

   Description of mark Sp. Brass Plate should be explicit, e.g., S/Steel Pillar Plate, Steel plug, Brass plug, Bolt, G.I. Pipe

   Height of mark 1.370 m. above ~~below~~ ~~rock~~/concrete; Mark is 1.470 m. above ~~below~~ G.L.

   Height of Top Vanes to Top ~~Mark~~/Pillar plate 1.450 m. Diameter of Vanes (vertical) .750 m.

   Height of Cairn ..... m. Diameter of Cairn ..... m. Name Plate ~~found~~/not ~~found~~/placed.

   Length of Mast ..... m. (approximate if not unpiled)
4. A Brass Plug set in conc/~~rock~~ has been ~~placed~~/found, bearing 179 °M from ~~Mast/Plug~~/Pillar
5. A S.S.M. set in conc/~~rock~~ has been ~~placed~~/found, bearing 138 °M from ~~Mast/Plug~~/Pillar
6. A G.I. Pipe set in conc/~~rock~~ has been ~~placed~~/found, bearing 169 °M from ~~Mast/Plug~~/Pillar
7. A ..... set in conc/rock has been placed/found, bearing ..... °M from Mast/Plug/Pillar
8. Action required: NAME PLATE NOT SUPPLIED

STANDPOINT: PILLAR PLATE

Mark	Direction	Horiz. Distance	Height Difference
INNES GS (OLD)	0 00 00		above ~~below~~ standpt.
KNOARADA GS (OP)	45 54 35		above ~~below~~ standpt.
S.S.M	299 46 05	4.497	1.337 above ~~below~~ standpt.
G.I. PIPE	330 48 25	7.993	1.264 above ~~below~~ standpt.
BRASS PLUG	340 28 05	4.975	1.865 above ~~below~~ standpt.
			above below standpt.
			above below standpt.

STANDPOINT: BRASS PLUG

Mark	Direction	Horiz. Distance	Height Difference
INNES GS (OLD)	0 00 00		above below standpt.
KNOARADA GS (OP)	45 54 00		above below standpt.
PILLAR	160 27 40	4.976	1.863 above ~~below~~ standpt.
S.S.M.	222 22 50	3.325	.527 above ~~below~~ standpt.
G.I. PIPE	315 30 30	3.203	.601 above ~~below~~ standpt.
			above below standpt.
			above below standpt.

Station Diagram — North — Not to Scale

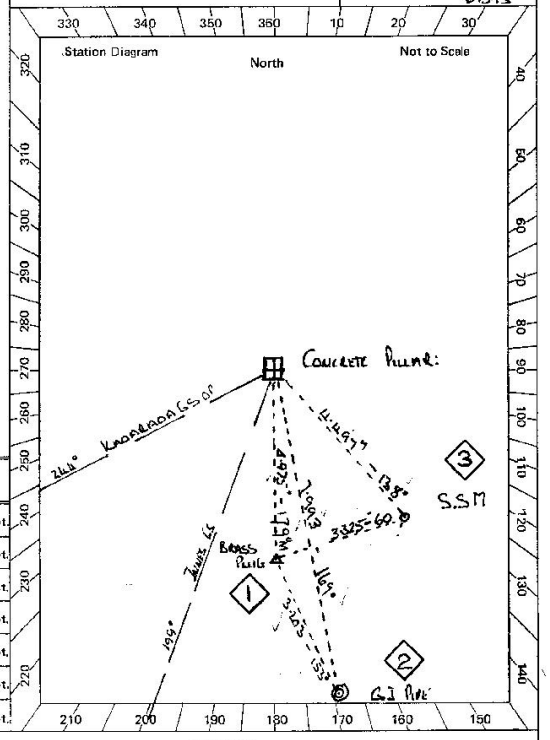

Prepared by: *Checked:* *Noted on U.T.M. Card* *Checked*

St 2733–1

TS6068 | Print Date: 31/05/2022 17:15 | No Of Pages: 2 | Property of DFSI – Spatial Services

TS6068 | Print Date: 31/05/2022 17:15 | No Of Pages: 2 | Property of DFSI – Spatial Services

St 2733—2 D. West, Government Printer

STATION Bunnoo Pillar 6068

Beacon Diagram — Not to Scale

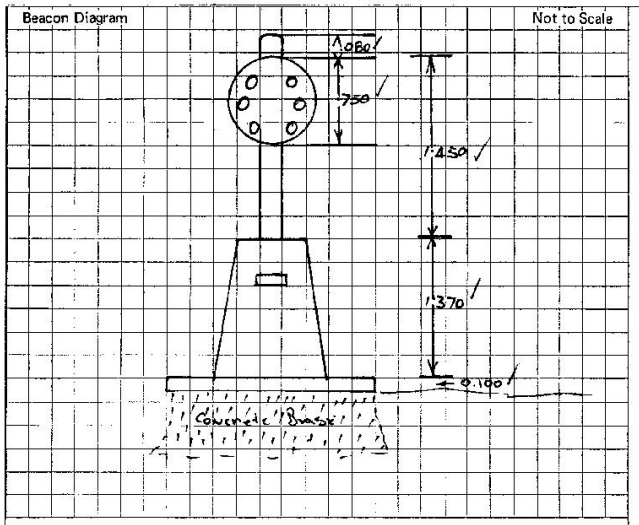

Owner's Name: Mr. Bill MacMillan

Address: Toms Creek

Phone:

Current Occupant: Mr. Bill MacMillan

Address: Toms Creek

Phone:

ACCESS 3-5-78

MY Access Report of 3./5./19 78 ~~was found suitable/unsuitable~~.

0.00	Combowie P.O Travelling towards Wingham
1.00	Turn ~~left~~ RIGHT Sign Bousford Rd. Ducks Ridge Rd
9.30	Take R. Hand Track (Straight ahead)
9.40	" " " " " "
9.50	Past Quarry
11.50	Iron Gate
11.55	Take Right Fork
11.40	Gate
12.10	Past Yards on R.H.S.
12.20	Wire Gate
12.50	Turn Left
13.80	Past Track on Right
15.45	Cross Gulch
16.40	Geodetic Station.

This section to be completed by officer constructing pillar.

Original station mark found/~~not found~~.

Description of mark: Brass Tablet Plug

Original beacon found/~~not found~~.

Description of beacon: Cairn, Mast + Vanes

Height Top of Vanes to Top Mark 3.622 m.

Height of mark .025 m. above/~~below~~ rock/conc .500 m. ~~above~~ below G.L.

Diameter of Vanes .610 m. Height of Cairn 1.200 m.

Original Beacon has/~~has not~~ been destroyed by me.

Date	Record of Station