CENTRAL MAPPING AUTHORITY

GEODETIC SURVEY OF N.S.W.

GEODETIC STATION RECONNAISSANCE and MAINTENANCE REPORT

STATION: GWABEGAR GS | TS No.: 6221

MAP SHEET SCALE 1:250 000: NARRABRI

INSPECTED BY: D. Halls | DATE: 4-9-1978

AUTHORITY: C.M.A. | FIELD BOOK: 1572/12

Description: *Note: Cross out word or words which do not apply*

1. Cleared by lanes bearing ..... from Trig. Mast
2. Mast & Vanes have been painted white & black respectively.
3. The station/~~pillar~~ was ~~unpiled/not unpiled~~/constructed on 4th Sept 19 78, dimensions now being:

   Description of mark: GI Pipe should be explicit, e.g., S/Steel Pillar Plate, Steel plug, Brass plug, Bolt, G.I. Pipe

   Height of mark: 0·02 m. above ~~below~~ ~~rock~~/concrete; Mark is: 0·01 m. ~~above~~ below G.L.

   Height of Top Vanes to Top Mark/Pillar plate ..... m. Diameter of Vanes (vertical) ..... m.

   Height of Cairn ..... m. Diameter of Cairn ..... m. Name Plate found/not found/placed.

   Length of Mast ..... m. (approximate if not unpiled)

4. A ..... set in conc/rock has been placed/found, bearing ..... °M from Mast/Plug/Pillar
5. A ..... set in conc/rock has been placed/found, bearing ..... °M from Mast/Plug/Pillar
6. A ..... set in conc/rock has been placed/found, bearing ..... °M from Mast/Plug/Pillar
7. A ..... set in conc/rock has been placed/found, bearing ..... °M from Mast/Plug/Pillar
8. Action required: .....

N.A.

STANDPOINT:

Mark	Direction	Horiz. Distance	Height Difference
			above / below standpt.
			above / below standpt.
			above / below standpt.
			above / below standpt.
			above / below standpt.
			above / below standpt.
			above / below standpt.

STANDPOINT:

Mark	Direction	Horiz. Distance	Height Difference
			above / below standpt.
			above / below standpt.
			above / below standpt.
			above / below standpt.
			above / below standpt.
			above / below standpt.
			above / below standpt.

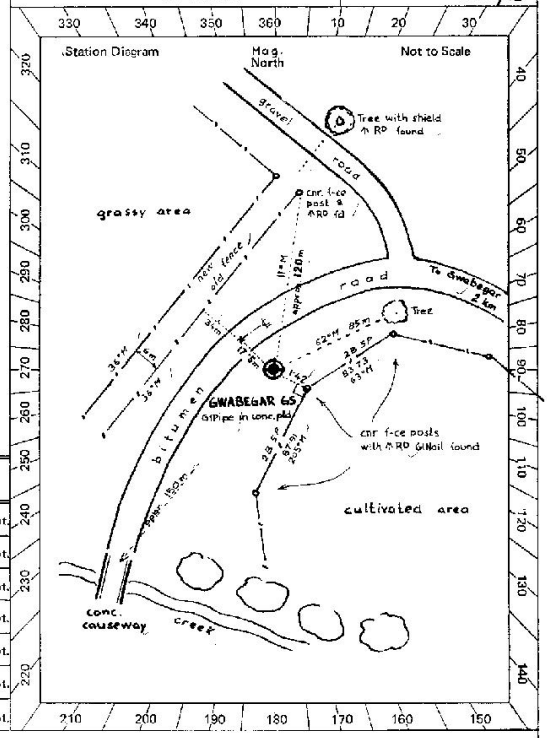

Prepared by: K. ZAHRA *Checked:* [illegible] 13/3/78 *Noted on U.T.M. Card* *Checked*

St 2733-1

TS6221 | Print Date: 31/05/2022 17:19 | No Of Pages: 2 | Property of DFSI – Spatial Services

TS6221 | Print Date: 31/05/2022 17:19 | No Of Pages: 2 | Property of DFSI – Spatial Services

St 2733–2 D. West, Government Printer

STATION GWABEGAR GS TS 6221

Beacon Diagram — Not to Scale

This section to be completed by officer constructing pillar.

Original station mark found/not found.

Description of mark: .....

Original beacon found/not found.

Description of beacon: .....

Height Top of Vanes to Top Mark .....m.

Height of mark.....m. above/below rock/conc.....m. above/below G.L.

Diameter of Vanes .....m. Height of Cairn .....m.

Original Beacon has/has not been destroyed by me.

Owner's Name: Public land

Address: .....

Phone: .....

Current Occupant: .....

Address: .....

Phone: .....

ACCESS 4-9-1978

Access Report ~~of ..../..../19 ... was found suitable/unsuitable.~~ original

0·0 km	From Gwabegar hotel head due West
0·6	travel straight ahead at intersection with Baradine (left) – Pilliga (right) road
1·0	Sawmill on left
1·2	road on left
1·5	road on right
1·6	" " "
1·7	" " "
1·8	G.S. on left

Date	Record of Station