Department of Lands

Integral Survey of N.S.W.

RECONNAISSANCE and MAINTENANCE REPORT 726

STATION BANKSTOWN TS 726

Co: CUMBERLAND | Ph: BANKSTOWN

Map Sheet: REGENTS PARK | No: 0045

Inspected by: | Date:

Authority | Field Book:

This Trig. Station has been:-

Note: Cross out word or words which do not apply

1. Completely cleared to permit 360° vision to surrounding Trigs.
2. Cleared by lanes bearing. ..... from Trig. Mast

ABSTRACT OF OBSERVATIONS

STATION BANKSTOWN ELEV. RES. (centre) R.L. 89.9 (Pin in Conc.) meters

To	R.L. (metres)	Direction or Vert. Ang.	Variance	Observer	Date	Dist. in metres at M.S.L.	Variance	Inst.	Observer	Date

See Reverse for Location Diagram.

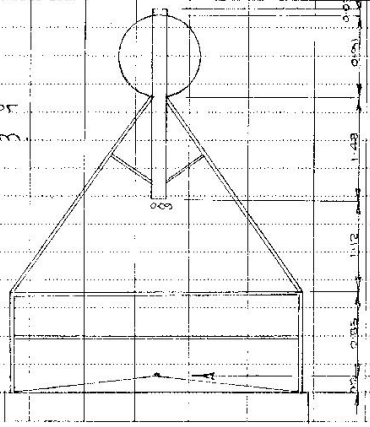

J. Nykl
31st Jan 1974

RL 89.9m (Lev. Dept of Lands Std Datum)
Pin in Conc.

Beacon Diagram — Not to Scale

rete Pillar

n.

llar

llar

llar

llar

All direct ons Corrected to centre

All Vert's corrected ground to ground

G 39

SEE REAR OF CARD FOR REMARKS

13. Diff. Ht. ..... is..... m. above / below .....

14. Diff. Ht. ..... is..... m. above / below .....

15. Diff. Ht. ..... is..... m. above / below .....

16. Diff. Ht. ..... is..... m. above / below .....

Prepared by: Checked:

Date	Record of Station

TS726 | Print Date: 31/05/2022 15:09 | No Of Pages: 2 | Property of DFSI – Spatial Services

STATION Bankstown TS 726

Station Diagram Not to Scale

North

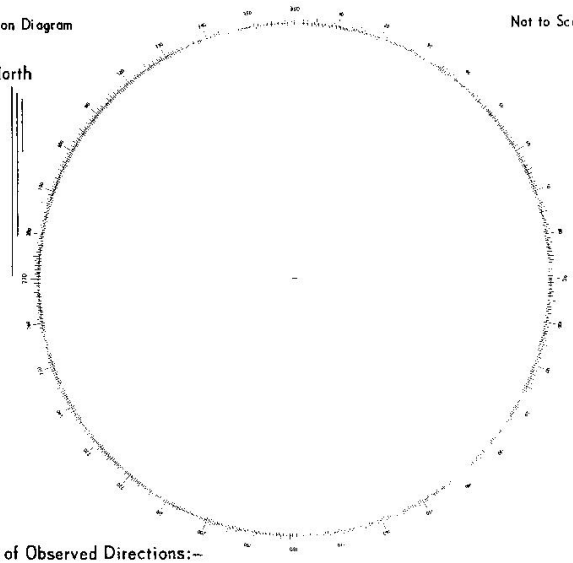

List of Observed Directions:–

Standpoint: Standpoint:

Station	Direction	Station	Direction

Station	Direction	Station	Direction

Owners Name..... Current Occupant.....

Address..... Address.....

.....

Access

Bankstown Elev. Res. (centre)

To Remarks

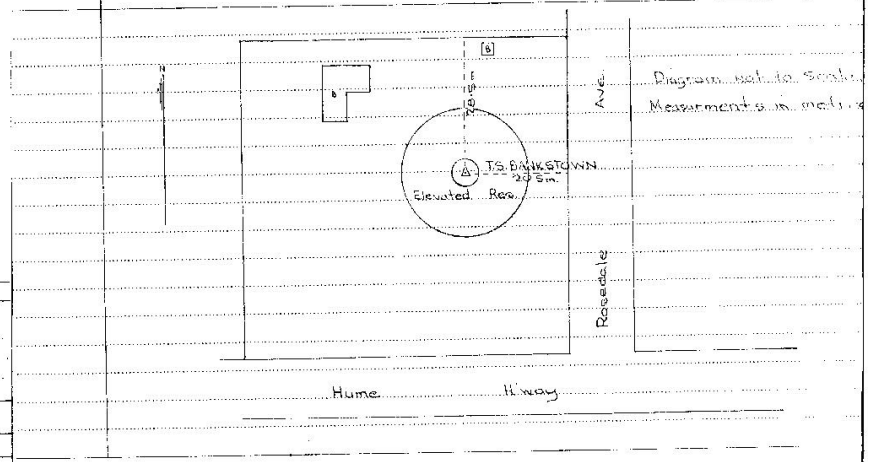

Diagram not to scale
Measurements in metres

D. West, Government Printer, New South Wales – 1976

TS726 | Print Date: 31/05/2022 15:09 | No Of Pages: 2 | Property of DFSI – Spatial Services