LAND INFORMATION CENTRE *GEODETIC SURVEY OF N.S.W.*

GEODETIC STATION RECONNAISSANCE and MAINTENANCE REPORT

STATION: WEE WAA RESERVOIR No.: TS 7332
MAP SHEET SCALE 1:250 000 WEE WAA
INSPECTED BY: L. HITCHINS DATE: 14-3-91
AUTHORITY: L.I.C. FIELD BOOK: C385

Description:

Note: Cross out word or words which do not apply

1. Cleared by lanes bearing 360° from Trig. Mast
2. Mast & Vanes have been painted white & black respectively. ✓
3. The ~~station~~/pillar was ~~unpiled/not unpiled~~/constructed on 7-3-1991, dimensions now being:

   Description of mark Rooftop Pillar should be explicit, e.g., S/Steel Pillar Plate, Steel plug, Brass plug, Bolt, G.I. Pipe

   Height of mark 1.450 m. above/~~below~~ ~~rock/concrete~~ Steel Floor; Mark is approx 33.0 m. above/~~below~~ G.L.

   Height of Top Vanes to Top ~~Mark~~/Pillar plate 1.445 m. Diameter of Vanes (vertical) 0.750 m.

   Height of Cairn — m. Diameter of Cairn — m. Name Plate ~~found~~/not ~~found~~/placed.

   Length of Mast — m. (approximate if not unpiled)
4. A PM70017 set in conc/~~rock~~ has been placed/~~found~~, bearing 167° °M from ~~Mast/Plug~~/Pillar approx 2KM
5. A SSM 14738 set in conc/~~rock~~ has been ~~placed~~/found, bearing 167° °M from Mast/Plug/Pillar approx 2KM NOT VISABLE
6. A
7. A) **It should be noted that if the position of the beacon is critical that the reservoir is built on a foundation deliberately designed to be capable of slight consolidation which may be uneven and that the reservoir is subject to thermal expansion and contraction when water content is at lower levels.** See 55/11 1536
8. Action required

STANDPOINT: PM70017

Mark	Direction	Horiz. Distance	Height Difference
top of s/o	0 00 00	-	above/below standpt.
WEE WAA RES.	43 45 30		above/below standpt.
SSM 14738	304 02 25	19.424	0.249 above/below standpt.
			above/below standpt.
			above/below standpt.
			above/below standpt.
			above/below standpt.
			above/below standpt.

STANDPOINT: SSM 14738

Mark	Direction	Horiz. Distance	Height Difference
top of S/o	0 00 00		above/below standpt.
PM 70017	123 30 30	19.427	0.244 above/below standpt.
			above/below standpt.
			above/below standpt.
			above/below standpt.
			above/below standpt.
			above/below standpt.

Station Diagram — North — Not to Scale

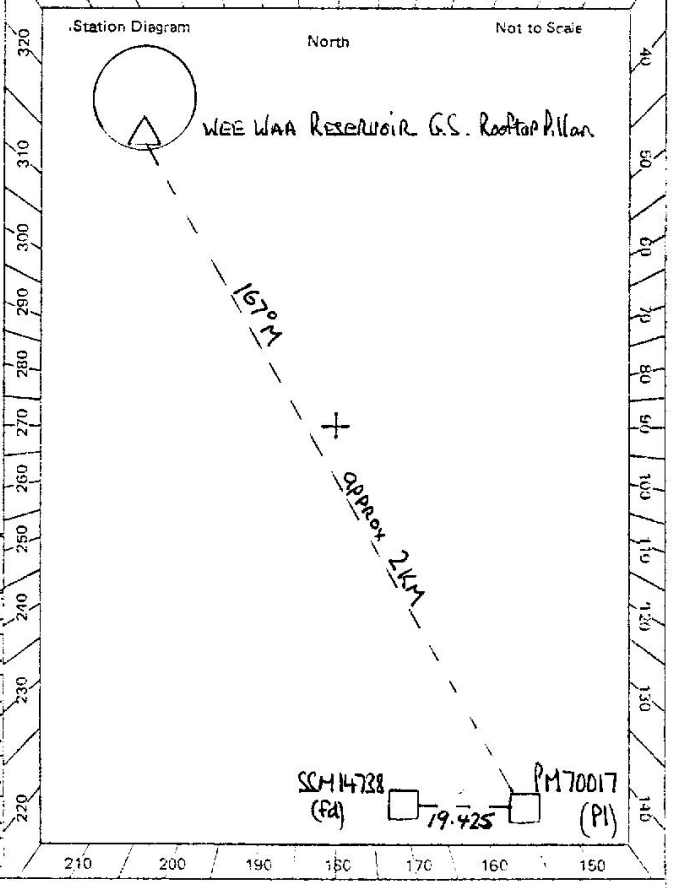

Prepared by: L.C Hall Checked: J Ford 6/4/91 Noted on U.T.M. Card Checked

2733–1

Gt 2733—2 D. West, Government Printer

STATION WEE WAA RESERVOIR TS 7332

Beacon Diagram — Not to Scale

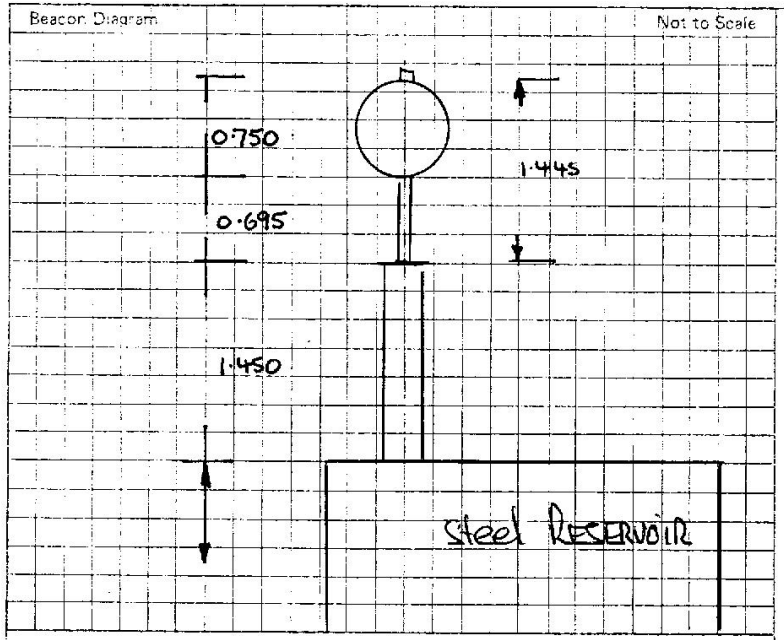

This section to be completed by office constructing pillar.

Original station mark found/not found.

Description of mark: .....

Original beacon found/not found.

Description of beacon: .....

Height Top of Vanes to Top Mark .....m.

Height of mark .....m. above/below rock/conc .....m. above/below G.L.

Diameter of Vanes .....m. Height of Cairn .....m.

Original Beacon has/has not been destroyed by me.

Owner's Name: NARRABRI SHIRE

Address: Council.

Call HEAD OFFICE (THEY CAN CONTACT Overseers by Radio if needed) 067 92 1699 (Engineering)

Phone: .....

Current Occupant: overseers

Address: Col Fogarty 95 4465 (H)

Ken GRAHAM 95 4591 (H)

Phone: .....

ACCESS

Access Report of 14.3./19.91 was found suitable/unsuitable.

KEY IS OBTAINABLE FROM WORKS DEPOT BURREN JUNCTION ROAD WEE WAA.

CALL EARLY WEEKDAYS (7.30) BEWARE EVERY 2ND FRI FLEXDAY

WEE WAA RESERVOIR IS BEHIND HOUSE NO 63 BOUNDARY STREET WEE WAA.

Date	Record of Station