CENTRAL MAPPING AUTHORITY — GEODETIC SURVEY OF N.S.W.

MSL Reduction ZAppm

GEODETIC STATION RECONNAISSANCE and MAINTENANCE REPORT

Description: *Note: Cross out word or words which do not apply*

1. Cleared by lanes bearing..... from Trig. Mast

~~2. Mast & Vanes have been painted white & black respectively.~~

3. The station/~~pillar~~ was ~~unpiled~~/not unpiled/~~constructed~~ on 22nd April ..... 19 91 ....., dimensions now being:

Description of mark Steel Pin ..... should be explicit, e.g., S/Steel Pillar Plate, Steel plug, Brass plug, Bolt, G.I. Pipe

Height of mark 0.01 .....m. ~~above~~ ~~below~~ ~~rock~~/concrete; Mark is 0.11 ..... m. ~~above~~ ~~below~~ G.L.

Height of Top Vanes to Top Mark/Pillar plate .....—.....m. Diameter of Vanes (vertical).....—.....m.

Height of Cairn.....—.....m. Diameter of Cairn.....—.....m. ~~Name Plate found/not found/placed.~~

Length of Mast .....—.....m. (approximate if not unpiled)

4. A.....set in conc/rock has been placed/found, bearing.....°M from Mast/Plug/Pillar
5. A.....set in conc/rock has been placed/found, bearing.....°M from Mast/Plug/Pillar
6. A.....set in conc/rock has been placed/found, bearing.....°M from Mast/Plug/Pillar
7. A.....set in conc/rock has been placed/found, bearing.....°M from Mast/Plug/Pillar
8. Action required:.....

STANDPOINT: Steel Pin in GI Pipe in Conc fd. STANDPOINT:

Mark	Direction	Horiz. Distance (MSL)	Height Difference	Mark	Direction	Horiz. Distance	Height Difference
EAST 103 MILEPOST	0° 00' 00"	82.436	0.115 above ~~below~~ standpt. ✓				above ~~below~~ standpt.
Top Cnr Steel Post ①	137° 54' 54"	53.020	1.154 above ~~below~~ standpt.				above ~~below~~ standpt.
⋀ in Coolabah ②	239° 12' 54"	14.142	above ~~below~~ standpt.				above ~~below~~ standpt.
⋀ in Coolabah ③	305° 57' 36"	23.554	above ~~below~~ standpt.				above ~~below~~ standpt.
			above ~~below~~ standpt.				above ~~below~~ standpt.
			above ~~below~~ standpt.				above ~~below~~ standpt.
			above ~~below~~ standpt.				above ~~below~~ standpt.

Prepared by: J Sutton 23.4.91 Checked: J Sutton 23.4.91 Noted on U.T.M. Card Checked

STATION: CULGOA PIN No.: 7339

MAP SHEETS SCALE 1:250 000 ANGLEDOOL SCALE 1:100 000 GOODOOGA

INSPECTED BY: J. SUTTON DATE: 22nd April, 1991

AUTHORITY: LIC FIELD BOOK: 1969

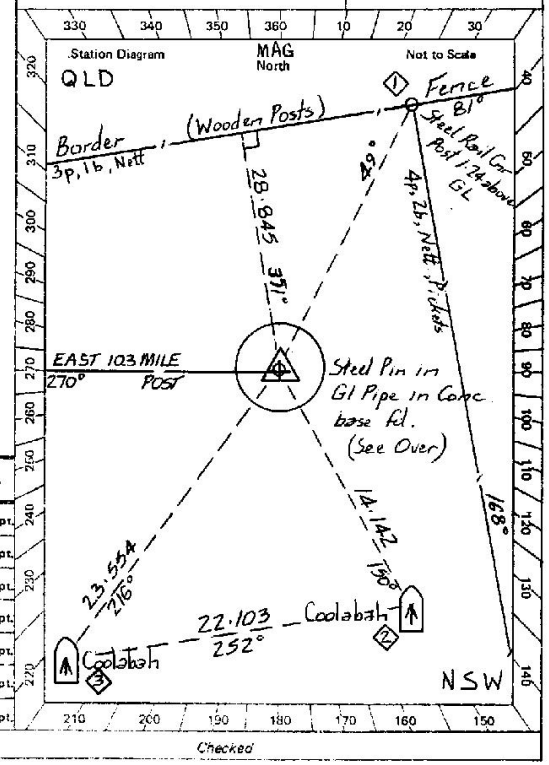

TS7339 | Print Date: 31/05/2022 18:19 | No Of Pages: 2 | Property of DFSI – Spatial Services

St 2733–2 D. West, Government Printer

STATION CULGOA PIN TS 7339

Beacon Diagram — Not to Scale

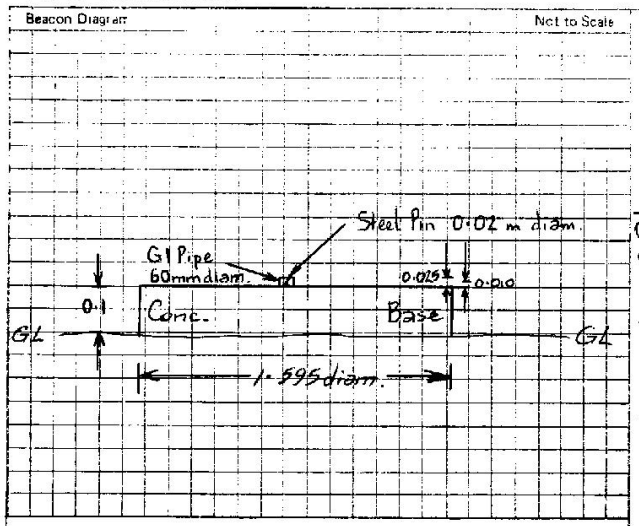

This section to be completed by officer constructing pillar.

Original station mark found/not found.

Description of mark: .....

Original beacon found/not found.

Description of beacon: .....

Height Top of Vanes to Top Mark.....m.

Height of mark.....m. above/below rock/conc.....m. above/below G.L.

Diameter of Vanes .....m. Height of Cairn .....m.

Original Beacon has/has not been destroyed by me.

Owner's Name: .....
Address: .....
.....
Phone: .....

Current Occupant: .....
Address: .....
.....
Phone: .....

ACCESS

Access Report of 22/1/1991 was found suitable/unsuitable.

Kms	
0·00	At bridge over Culgoa River South of Brenda Gate — head North.
0·4	Turn right onto track and follow main track.
1·41	Through iron gate.
5·12	Through gate in boundary fence, then turn right along fence.
7·94	Vere left along fence.
8·12	Turn right and go through gate, turning right along fence.
8·3	Turn left along border fence.
8·5	Turn right and go through gate, then turn left along fence.
8·69	By-pass 103 Mile Post.
8·78	Culgoa Pin 100 metres before Culgoa River.

Dry Weather Access ONLY

Date	Record of Station

TS7339 | Print Date: 31/05/2022 18:19 | No Of Pages: 2 | Property of DFSI – Spatial Services