Batch Id 1495 Mile Post 180 East
Batch Id 1523 M/POST 180 EAST RM1

LAND INFORMATION CENTRE — *GEODETIC SURVEY OF N.S.W.*

GEODETIC STATION RECONNAISSANCE and MAINTENANCE REPORT

STATION: MILE POST 180 EAST (M/POST 180 EAST RM1) — No: 7392 / No.: 7343

MAP SHEET SCALE ~~1:250 000~~ MOGIL MOGIL 1:100.000

INSPECTED BY: G. FORD — DATE: 28/2/91

AUTHORITY: L.I.C — FIELD BOOK: 2103

Mag Decl 10°30'

Description: *Note: Cross out word or words which do not apply*

1. Cleared by lanes bearing.....from Trig. Mast
2. Mast & Vanes have been painted white & black respectively.
3. The station/pillar was unpiled/~~not unpiled~~/constructed on 28/2/91 19......, dimensions now being: D.H.& projected centre of old
   Description of mark WOODEN MILE POST should be explicit, e.g., S/Steel Pillar Plate, Steel plug, Brass plug, Bolt, G.I. Pipe
   Height of mark.....m. above/below rock/concrete; Mark is 0.70 m. above/~~below~~ G.L.
   Top of wooden M.Post = 0.87 abv. GL
   Height of Top Vanes to Top Mark/Pillar plate .....m. Diameter of Vanes (vertical).....m.
   Height of Cairn.....m. Diameter of Cairn.....m. Name Plate found/not found/placed.
   Length of Mast .....m. (approximate if not unpiled)
4. A S/S ~~Pin~~ Rod (RM1) set in ~~conc/rock~~ SOIL has been placed/~~found~~ UNDER COVER BOX, bearing 315 °M from ~~Mast/Plug/Pillar~~ 180 MILE POST
5. A S/S ~~Pin~~ Rod (RM2) set in ~~conc/rock~~ SOIL has been placed/~~found~~ UNDER COVER BOX, bearing 173 °M ~~from Mast/Plug/Pillar~~ TO 180 M.P.
6. A BLAZED TREE set in conc/rock has been ~~placed~~/found, bearing 226° °M from ~~Mast/Plug/Pillar~~ 180 M.P.
7. A BLAZED TREE set in conc/rock has been ~~placed~~/found, bearing 119° °M from ~~Mast/Plug/Pillar~~ 180 M.P.
   GI STAR PICKET " " SOIL " " " " 353°M " 180 M.P.
8. Action required:.....

STANDPOINT:

Mark	Direction	Horiz. Distance	Height Difference	Mark	Direction	Horiz. Distance	Height Difference
			above/below standpt.				above/below standpt.
			above/below standpt.				above/below standpt.
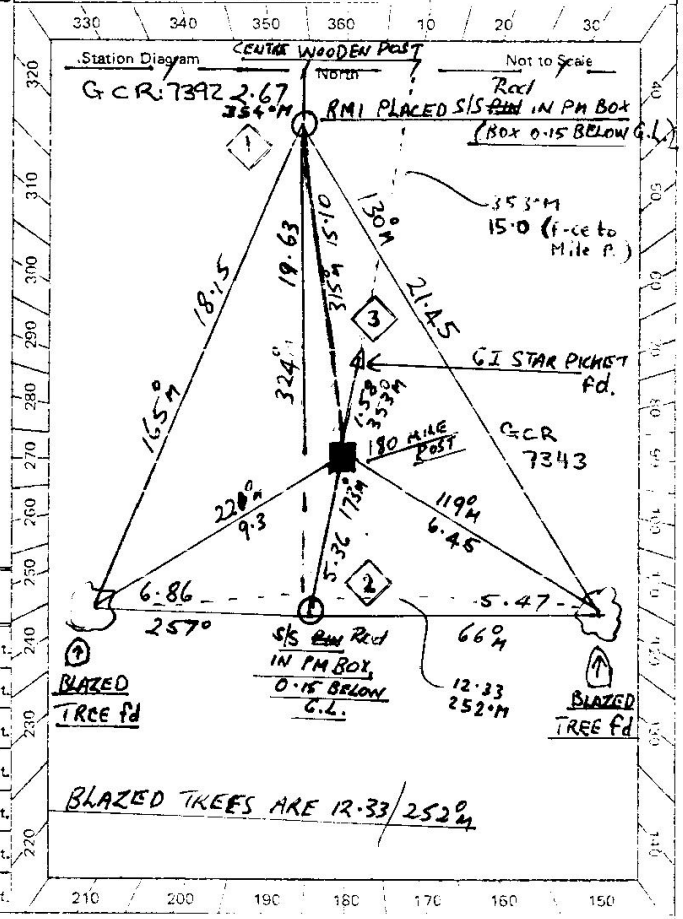

Prepared by: [signature] Checked: [signature] Noted on U.T.M. Card Checked

S: 2733–1

TS7343 | Print Date: 31/05/2022 18:19 | No Of Pages: 2 | Property of DFSI – Spatial Services

TS7343 | Print Date: 31/05/2022 18:19 | No Of Pages: 2 | Property of DFSI – Spatial Services

TS.7343 } same card

STATION TS 7392 } MILE POST 180 EAST

St 2733–2 D. West, Government Printer

Beacon Diagram — Not to Scale

Owner's Name: .....

Address: .....

.....

Phone: .....

Current Occupant: .....

Address: .....

.....

Phone: .....

ACCESS

Access Report of 28/2/1991 was found suitable/unsuitable.

0.00 CLODES GATE (WEST OF MUNGINDI) HEAD WEST ALONG BORDER FENCE.

0.95 180 MILE POST on left

This section to be completed by officer constructing pillar.

Original station mark found/not found.

Description of mark: .....

Original beacon found/not found.

Description of beacon: .....

Height Top of Vanes to Top Mark.....m.

Height of mark.....m. above/below rock/conc.....m. above/below G.L.

Diameter of Vanes .....m. Height of Cairn .....m.

Original Beacon has/has not been destroyed by me.

Date	Record of Station
30.4.91	RM