CENTRAL MAPPING AUTHORITY

Department of Lands

Trigonometrical Survey of N.S.W.

RECONNAISSANCE and MAINTENANCE REPORT 740

SEE ALSO TS10465 MARYVALE (P)

STATION BARE HILL NOW KNOWN AS MARYVALE

Co:	Ph:
Map Sheet: MUSWELLBROOK	No: 9033 N
Inspected by: P CHEN	Date: 25/4/77
Authority C.M.A.	Field Book: 1565

This Trig. Station has been:- *Note: Cross out word or words which do not apply*

1. Completely cleared to permit 360° vision to surrounding Trigs.
2. ~~Cleared by lines bearing~~ ..... from Trig. Mast
3. ~~Trig. Mast & Vanes have been painted white & black respectively~~.
4. The Trig. was unpiled/~~not unpiled~~, dimensions now being: Cairn & Station Mark found, ~~not found~~

   Description of mark G.I. PIPE ..... should be explicit, e.g. Steel plug, Brass plug, Bolt, G.I. Pipe

   Height of mark — m above/below rock/concrete — m above/below G.L.

   Height of Top Vanes to Top Mark 2.1 m. Diameter of Vanes (vertical) 0.75 m.

   Height of Cairn — m. Diameter of Cairn — m.

   Length of Mast 1.35 m. (approximate if not unpiled)
5. A.....set in conc/rock has been placed.....m. bearing.....°M from Trig. Mast
6. A.....set in conc/soil has been placed.....m. bearing.....°M from Trig. Mast
7. A.....set in conc/soil has ~~been placed~~.....m. bearing.....°M from Trig. Mast
8. A.....set in ~~conc/rock~~ has been placed.....m. bearing.....°M from Trig. Mast
9. Connection.....to..... : ..... m. bearing.....°M
10. Connection.....to..... : ..... m. ~~bearing~~.....°M
11. Connection.....to..... : ..... m. bearing.....°M
12. Connection.....to..... : ..... m. bearing.....°M
13. Diff. Ht. ..... is..... m. above/below .....
14. Diff. Ht. ..... is..... m. above/below .....
15. Diff. Ht. ..... is..... m. above/below .....
16. Diff. Ht. ..... is..... m. above/below .....

Beacon Diagram — Not to Scale

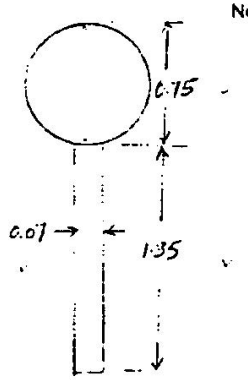

Date	Record of Station

Prepared by: P CHEN Checked: Noted on U.T.M. Card Checked

TS740

TS740 | Print Date: 31/05/2022 15:09 | No Of Pages: 2 | Property of DFSI – Spatial Services

SEE ALSO TS10465 MARYVALE (P)

740 STATION BARE HILL/NOW KNOWN AS MARYVALE

Station Diagram

Not to Scale

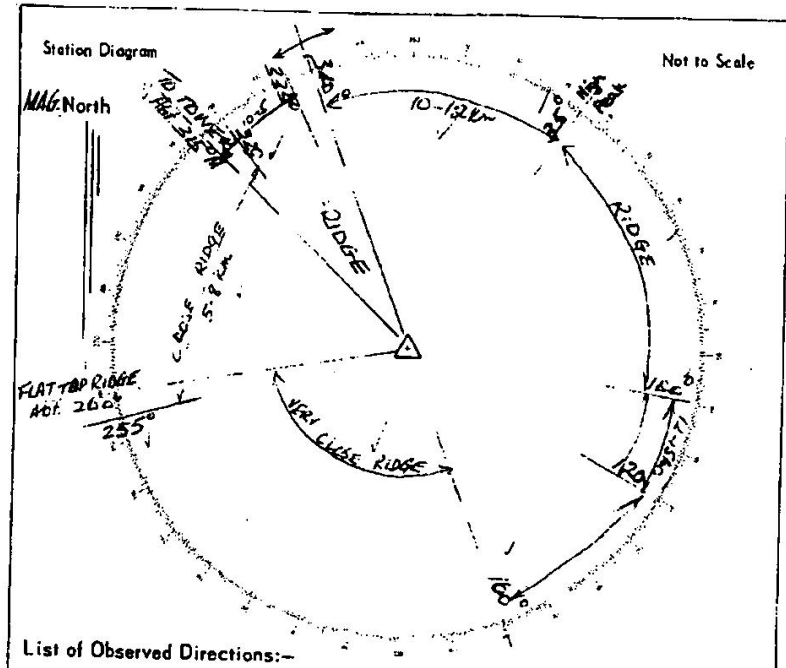

List of Observed Directions:–

Standpoint:

Station	Direction	Station	Direction

Standpoint:

Station	Direction	Station	Direction

Owners Name. MRS MARIE TERESE CASEY

Address. RMB 464 "MARYVALE" KAYUGA

Current Occupant.....

Address.....

Access (1977)

KM	Features
0.0	Muswellbrook P.O. take new england highway towards Tamworth
1.2	Pass road on right, go st. ahead.
1.5	T-Intern. take road to "Sandy Hollow" on right.
2.0	T Inter. turn right take road to "Kayuga" & cross bridge. Keep on main road
6.2	T intern. go st. ahead
6.4	Pass road on right. go ahead
8.1	cross intern. turn left
10.6	take right fork
12.1	Owner's home P.R. immediately pass home, turn left, go thru wooden gate, pass house, turn right & follow wire fence to iron gate.
12.3	Go thru iron gate, turn left & follow fence line up hill
12.8	end of fence, turn left and make your own way along ridge of top of hill
13.4	at trig.

TS740 | Print Date: 31/05/2022 15:09 | No Of Pages: 2 | Property of DFSI – Spatial Services